


2005-055

© JERRY TURNER & ASSOCIATES, INC. THIS DOCUMENT IS THE PROPERTY OF JERRY TURNER & ASSOCIATES. ALL RIGHTS ARE RESERVED AND ANY POSSESSION, REPRODUCTION, OR OTHER USE OF THIS DOCUMENT WITHOUT THE PRIOR PERMISSION OF JERRY TURNER & ASSOCIATES IS EXPRESSLY PROHIBITED.

SITE PLAN APPROVAL
 Planning Dept. Paul Doherty 5-20-05
 Name & Date
 All Applications For Permits Must Conform
 In Every Respect To These Approved Plans

LEGEND

- | | | |
|--|----------------|----------|
| Exist. Trees to Remain | New Trees | |
| Exist. Coconut Palm | Coconut Palm | Pink Tab |
| Exist. Sabal Palm | Royal Palm | |
| Exist. Slash Pine | Gumbo Limbo | |
| Exist. Shade Tree | Mahogany | |
| (See Sheet L-3 for Exist. Tree Legend) | Areca Palm | |
| | Reclinata Palm | |
| | Gumbo Limbo | |
| | Wax Myrtle | |
| | Sabal Palm | |

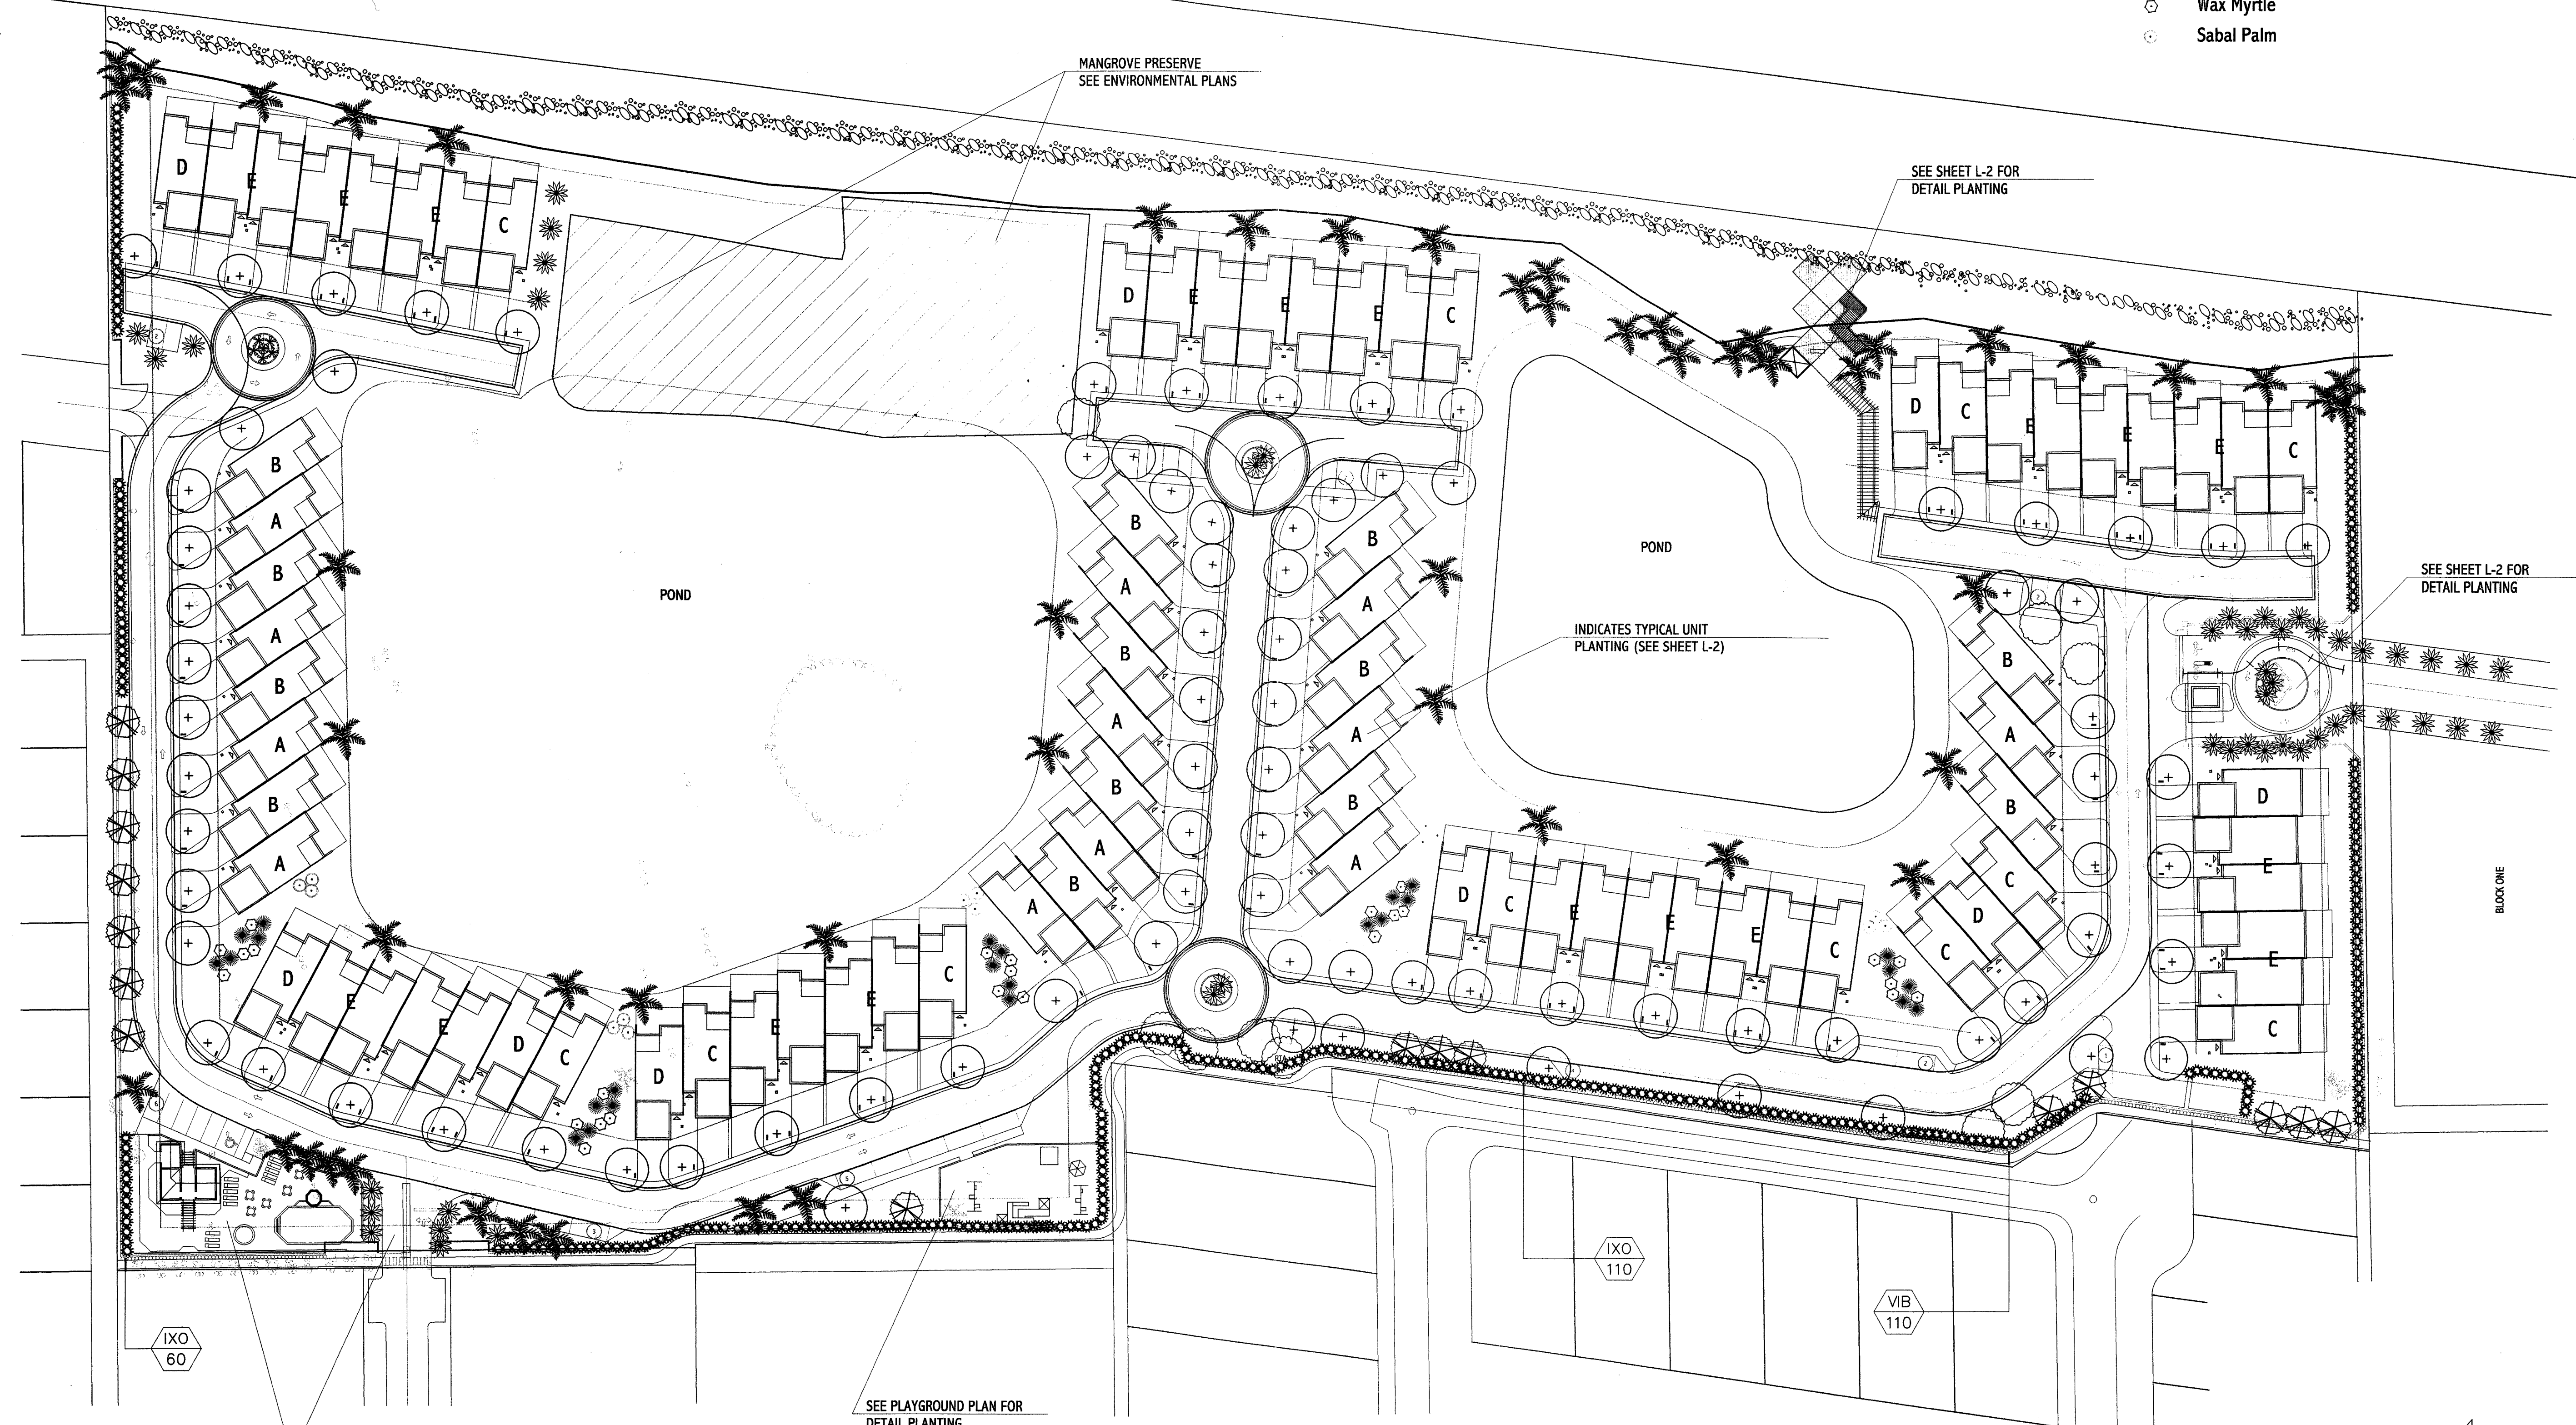

JTA
JERRY TURNER & ASSOCIATES

LANDSCAPE ARCHITECTURE
 LAND PLANNING
 ENVIRONMENTAL DESIGN

905 JONES FRANKLIN ROAD
 RALEIGH, NORTH CAROLINA 27608
 (919) 851-7150
 277 S.E. 5th AVENUE
 DELRAY BEACH, FLORIDA 33483
 (561) 276-0453

PROJECT
THE ESTUARY
 RECEIVED
 APR 17 2005
 PLANNING & ZONING

Delray Beach, FL
 REVISIONS
 12/11/98
 5/21/99
 12/07/04 as-built
 as-built applies only to common
 area landscaping

DRAWN _____ CHECKED _____
 DTO _____ DTO _____
 SCALE _____ DATE _____
 1"=50' 10/30/98

**OVERALL
 LANDSCAPE
 PLAN**

FILE NO. _____ JOB NO. _____
 NEWSITE/L-1 5223
 SEAL _____ SHEET NO. _____

[Signature] L-1
 OF 4